



This drawing is copyright & the property of WAND Projects Ltd & must not be copied in whole or in part without their written permission. Copyright is reserved. ©
 This drawing must not be scaled. The Contractor is to report all dimensional discrepancies & errors to the Contract Administrator prior to construction commencing.
 It is essential that this drawing is read in conjunction with all specifications/schedule of works & that all works are included for.

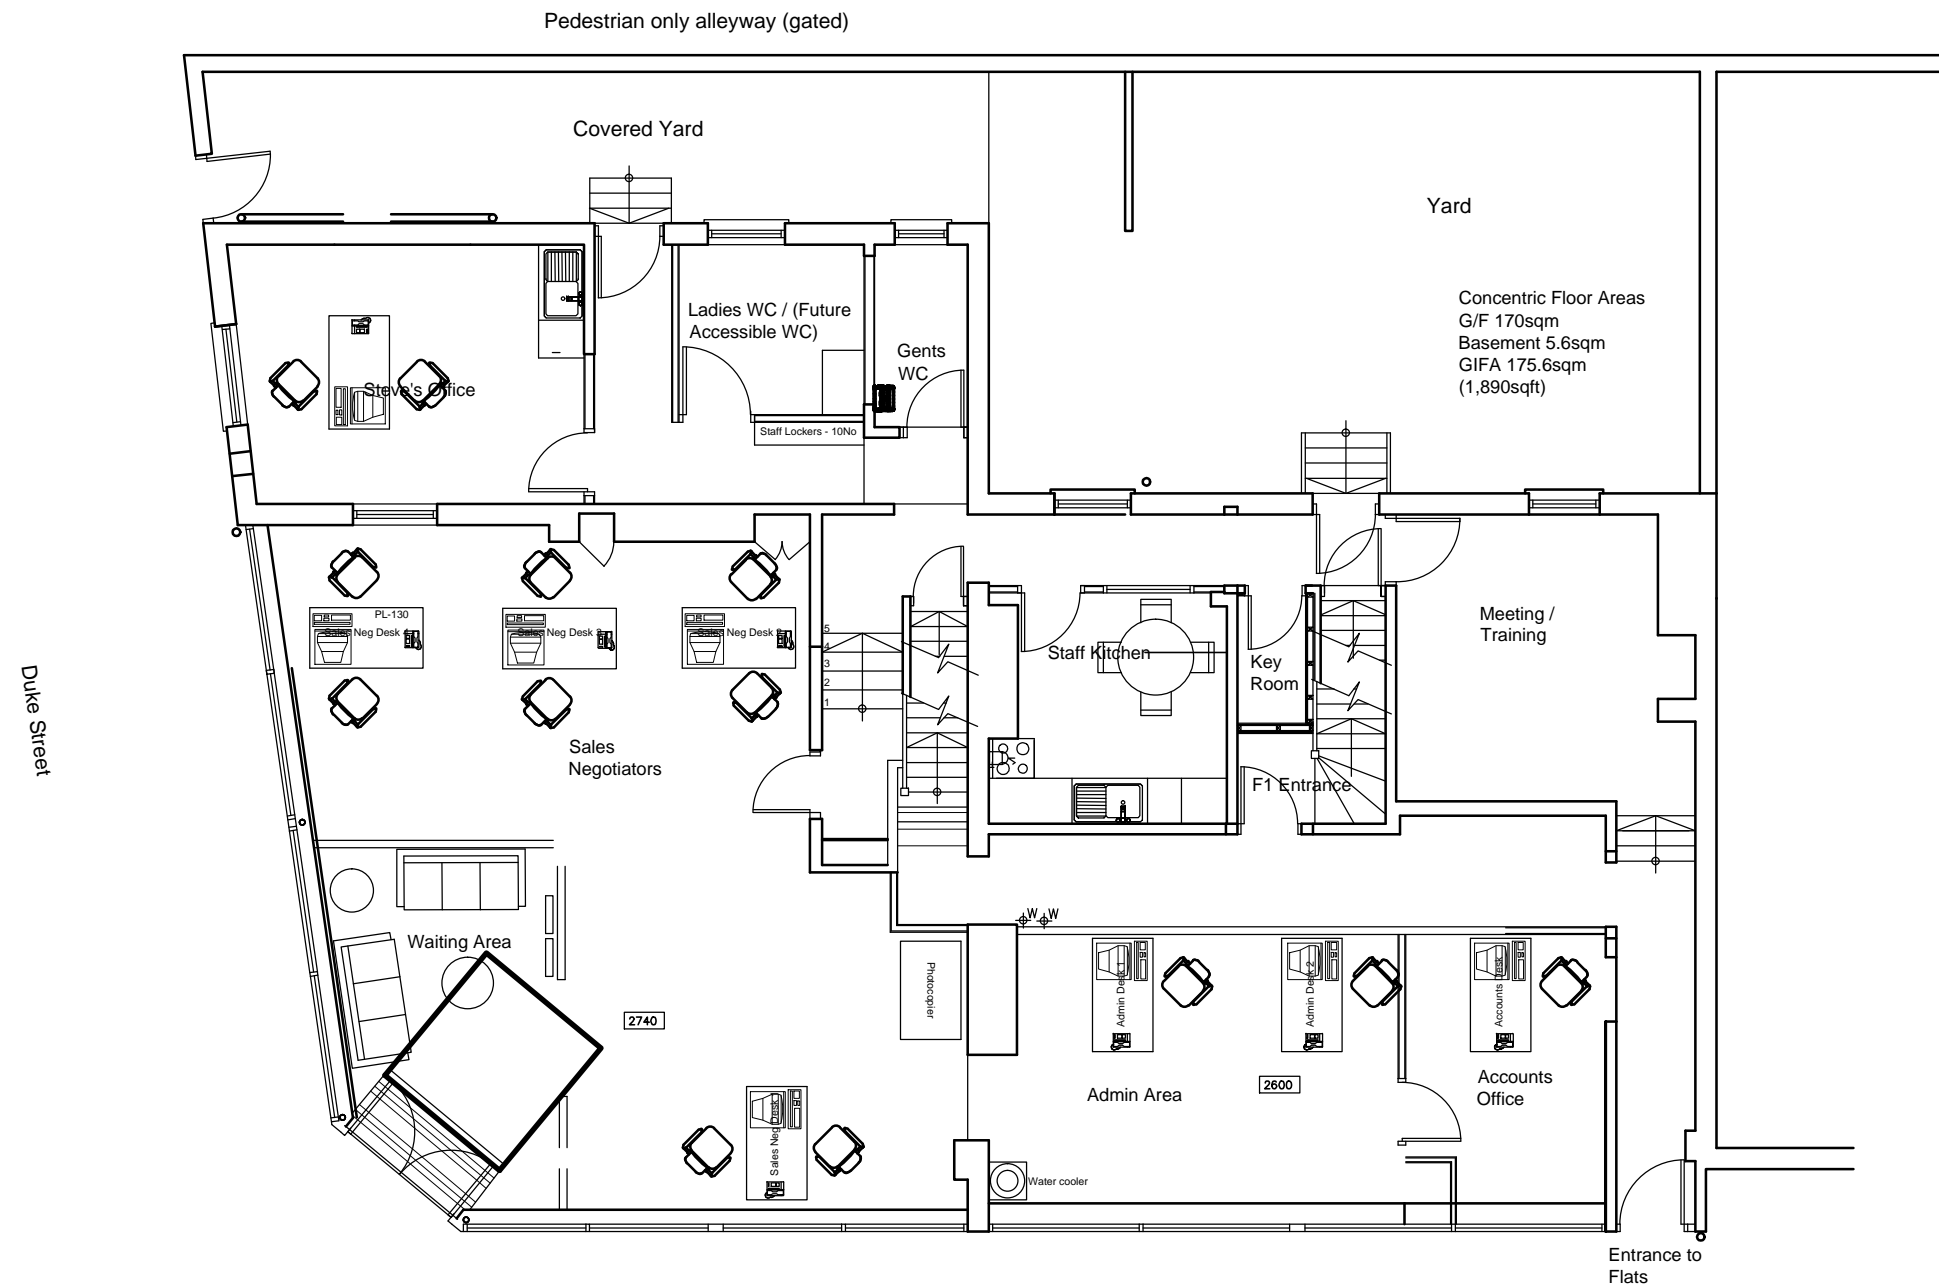

PROPOSED GROUND FLOOR PLAN

Mount Pleasant

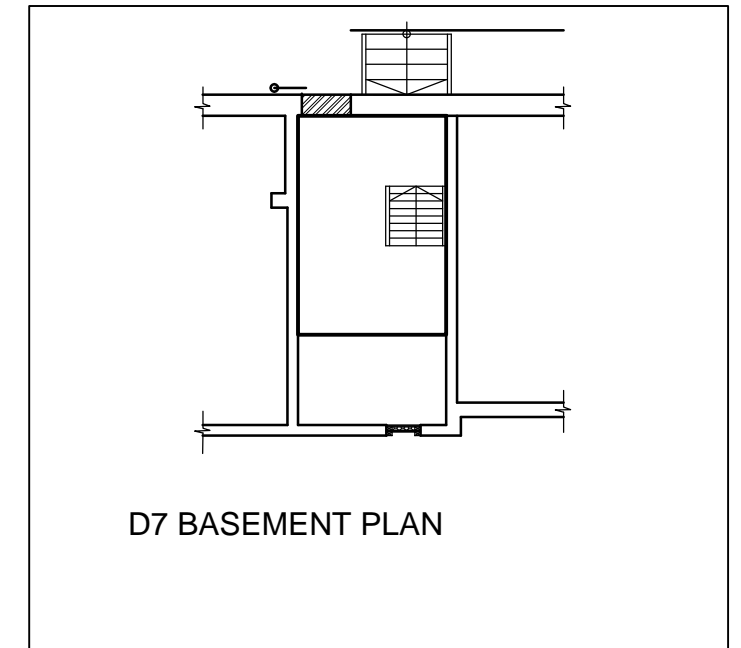

D7 BASEMENT PLAN

Concentric Floor Areas
 G/F 170sqm
 Basement 5.6sqm
 GIFA 175.6sqm
 (1,890sqft)

Revisions	Comments	Dates
Status		
<input type="radio"/> Feasibility	<input type="radio"/> Tender	<input type="radio"/> For Client Approval
<input type="radio"/> Planning	<input type="radio"/> Construction	<input type="radio"/> Preliminary
<input type="radio"/> Building Regulations	<input checked="" type="radio"/> As Built	
Client	Concentric Lettings	Date 24/07/2012
		Drawn MAD
Project Title	19 - 21 Mount Pleasant, Waterloo, L22 5PL	Approved
	Refurbishment & Extension	Scale 1:100 @ A3
Drawing Title	As-Built GA Plan	Job No. 211/008
		Dwg No. AB-01



Suite A, 62 Liverpool Road, Crosby, Liverpool, L23 5SJ, United Kingdom
 tel: 0151 924 4533 fax: 0151 331 0251
 e-mail: info@wandprojects.com
 web: www.wandprojects.com